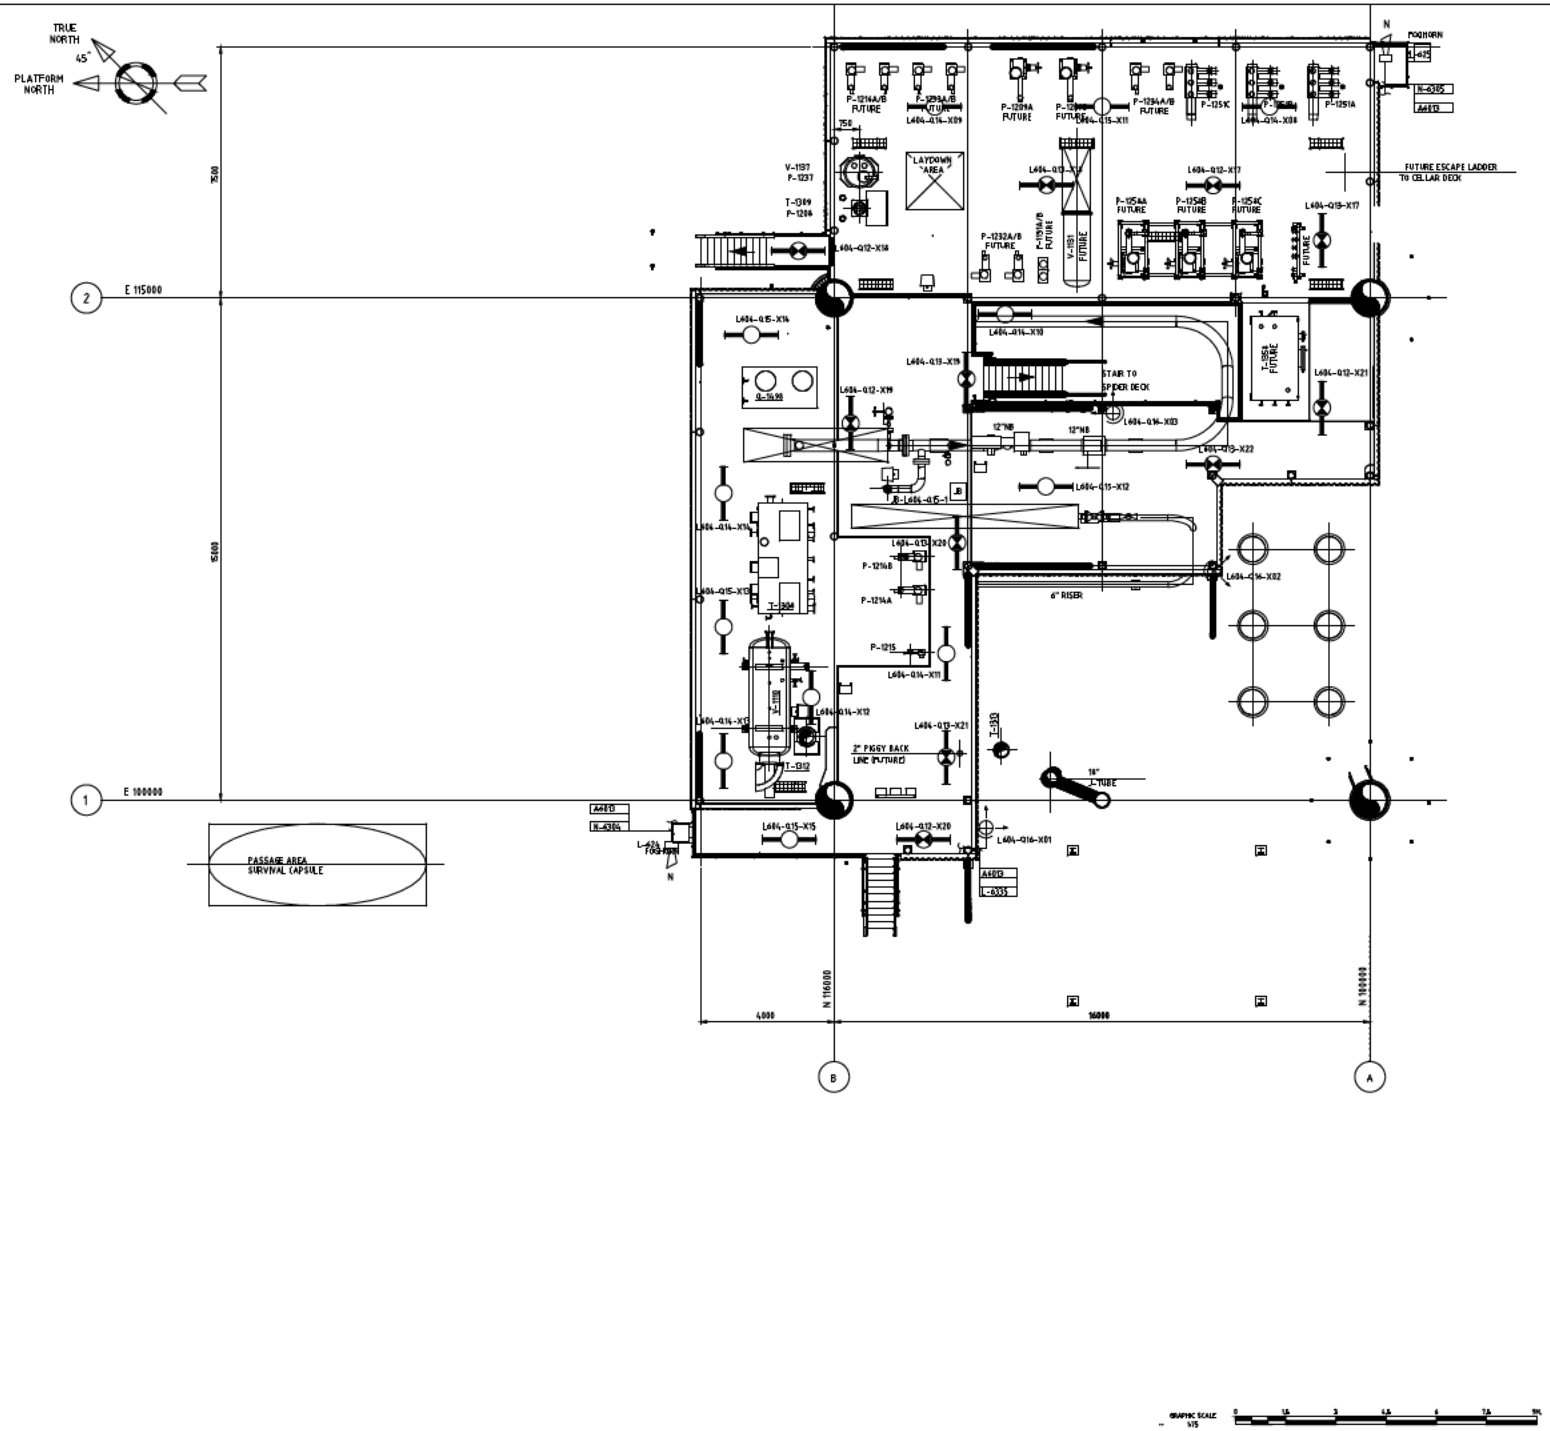


GRAPHIC SCALE 1:75

REFERENCE DRAWINGS

DRAWING NO.	DESCRIPTION
694-1	ELECTRICAL CABLE SCHEDULE
A6001	ELECTRICAL LEGEND AND SYMBOLS
A6013	POWER AND EARTH. LAYOUT SUB-CEL. DECK
A6035	EARTHING DETAILS
A6065	ONE LINE DIAGRAM NAV. AIDS L-603
A6070	ONE LINE DIAGRAM LTG DB L-604

NOTES

1. ALL LIGHTING FIXTURES, FOR NORMAL AND EMERGENCY LIGHTING, AND FOR ALL CONVENIENCE 230VAC-OUTLETS, ARE FED BY LIGHTING AND SMALL POWER DISTRIBUTION BOARD L-604.
2. LIGHTING CIRCUIT FEEDER POINT USED ON LIGHTING LAYOUTS :
   EXAMPLE: L-6824 (CABLE NUMBER) / A6017 (REFERENCE TO LAYOUT)
3. LIGHTING FIXTURE CODES USED ON LIGHTING LAYOUTS:
   EXAMPLE: A-Bxx — SEQUENCE NUMBER (determined by installation contractor) / FIXTURE IDENTIFICATION CODE / CIRCUIT NUMBER OF DISTRIBUTION BOARD L-604
4. CONVENIENCE OUTLETS CODES USED ON LIGHTING LAYOUTS:
   EXAMPLE: T-Pxx — SEQUENCE NUMBER (determined by installation contractor) / OUTLET IDENTIFICATION CODE / CIRCUIT NUMBER OF DISTRIBUTION BOARD L-604
5. UNLESS OTHERWISE INDICATED, ALL CEILING/WALL MOUNTED LIGHTING FIXTURES ARE MOUNTED APPROX. 2500mm ABOVE FINISHED FLOOR (BOTTOM OF LIGHTING FIXTURES).
6. FIXTURES SHALL BE RELOCATED IN CASE OF CLASHES WITH PIPING AND/OR STRUCTURAL STEEL.
7. NAV. AID EQUIPMENT IS FED FROM L-603 OR L-624

LEGEND

DESIGN IS BASED ON THE FOLLOWING :
ORDI

A		FLUORESCENT LIGHTING FIXTURE TYPE:EXCALIBUR VL19E (76W), ATEX II 2GD EEx en II T4 WITH BI-pin LAMPS (2x36W) MAKE:VICTOR
B		EMERGENCY FLUORESC. LIGHT. FIXT. WITH BATTERY BACK-UP TYPE:EXCALIBUR VL24E (86W), ATEX II 2GD EEx en II IIC T4 WITH BI-pin LAMPS (2x36W); EMERG DURATION 3 HOURS. MAKE:VICTOR
C	RD	EXPLOSIONPROOF OBSTRUCTION LUMINAIRE TYPE:6LU5 (85W), ATEX-2 II 2GD EEx me II T4; Red glass MAKE:MT
D		EXPLOSIONPROOF OBSTRUCTION LUMINAIRE TYPE:6LU5 (85W), ATEX-2 II 2GD EEx me II T4 MAKE:MT
E		EXPLOSIONPROOF LUMINAIRE TYPE:6LU5 (85W), ATEX-2 II 2GD EEx me II T4 MAKE:MT
F		FLOOD LIGHT TYPE:FL40 SA (400W), LAMP TYPE:HP, SODIUM EXPL.-PROOF EEmbe II T; T3 MAKE:MT
G	E	EMERGENCY EXIT TRITIUM LIGHTING (21VA) TYPE:- MAKE:D FOM b.v.NL.
K		EXPLOSIONPROOF SEARCH LIGHT TYPE:FL270 (W), EEx de IIB T3; 24V+-A; HALOGEN LAMP (2x70W) MAKE:MT
N		DIRECTIONAL FOGHORN TYPE:FH400 (3) Ex MAKE:ARGA

REV	DATE	BY	DESCRIPTION	CHK'D	APP'D
03	17.04.25	JLA	AS BUILT (WO A30387)		
02	30.03.18	JLA	AS BUILT		
2	30.03.18	SJO	AS BUILT (WO 480550)		
0	11.09.09	SBO	AS BUILT A3070		

5.1.2.e

EN ENERGY NETHERLANDS B.V. SECTION NO. —

ENGIE

PLATFORM: L7-F

TITLE: LIGHTING AND NAV. AIDS LAYOUT SUB-CELLAR DECK T.O.S. EL. +18.000

SCALE	DRAWING No.	SHEET No.	SIZE
1:75	A6020	0001	A1
JOB No. A30387			REV 03